



West 44th Street

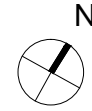

Fifth Avenue

SCALE: N.T.S.

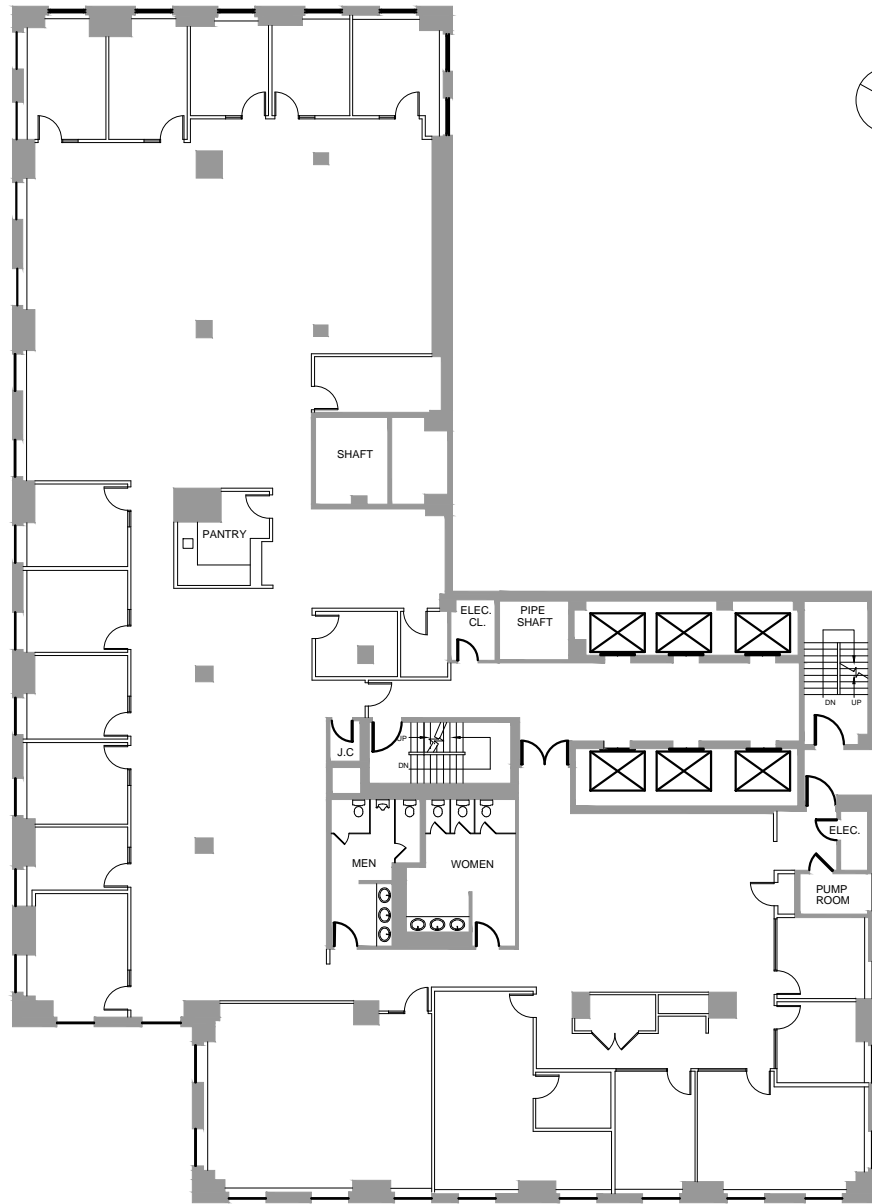

16th FLOOR
AS-BUILT

FLOOR 16
530 FIFTH AVENUE
NEW YORK, NEW YORK

PROJECT LOCATION	
FILE NAME	16th Floor AS-Built
DATE	11/17/2011
DRAWN BY	D. Borjas
DRAWING NO. DS-1	